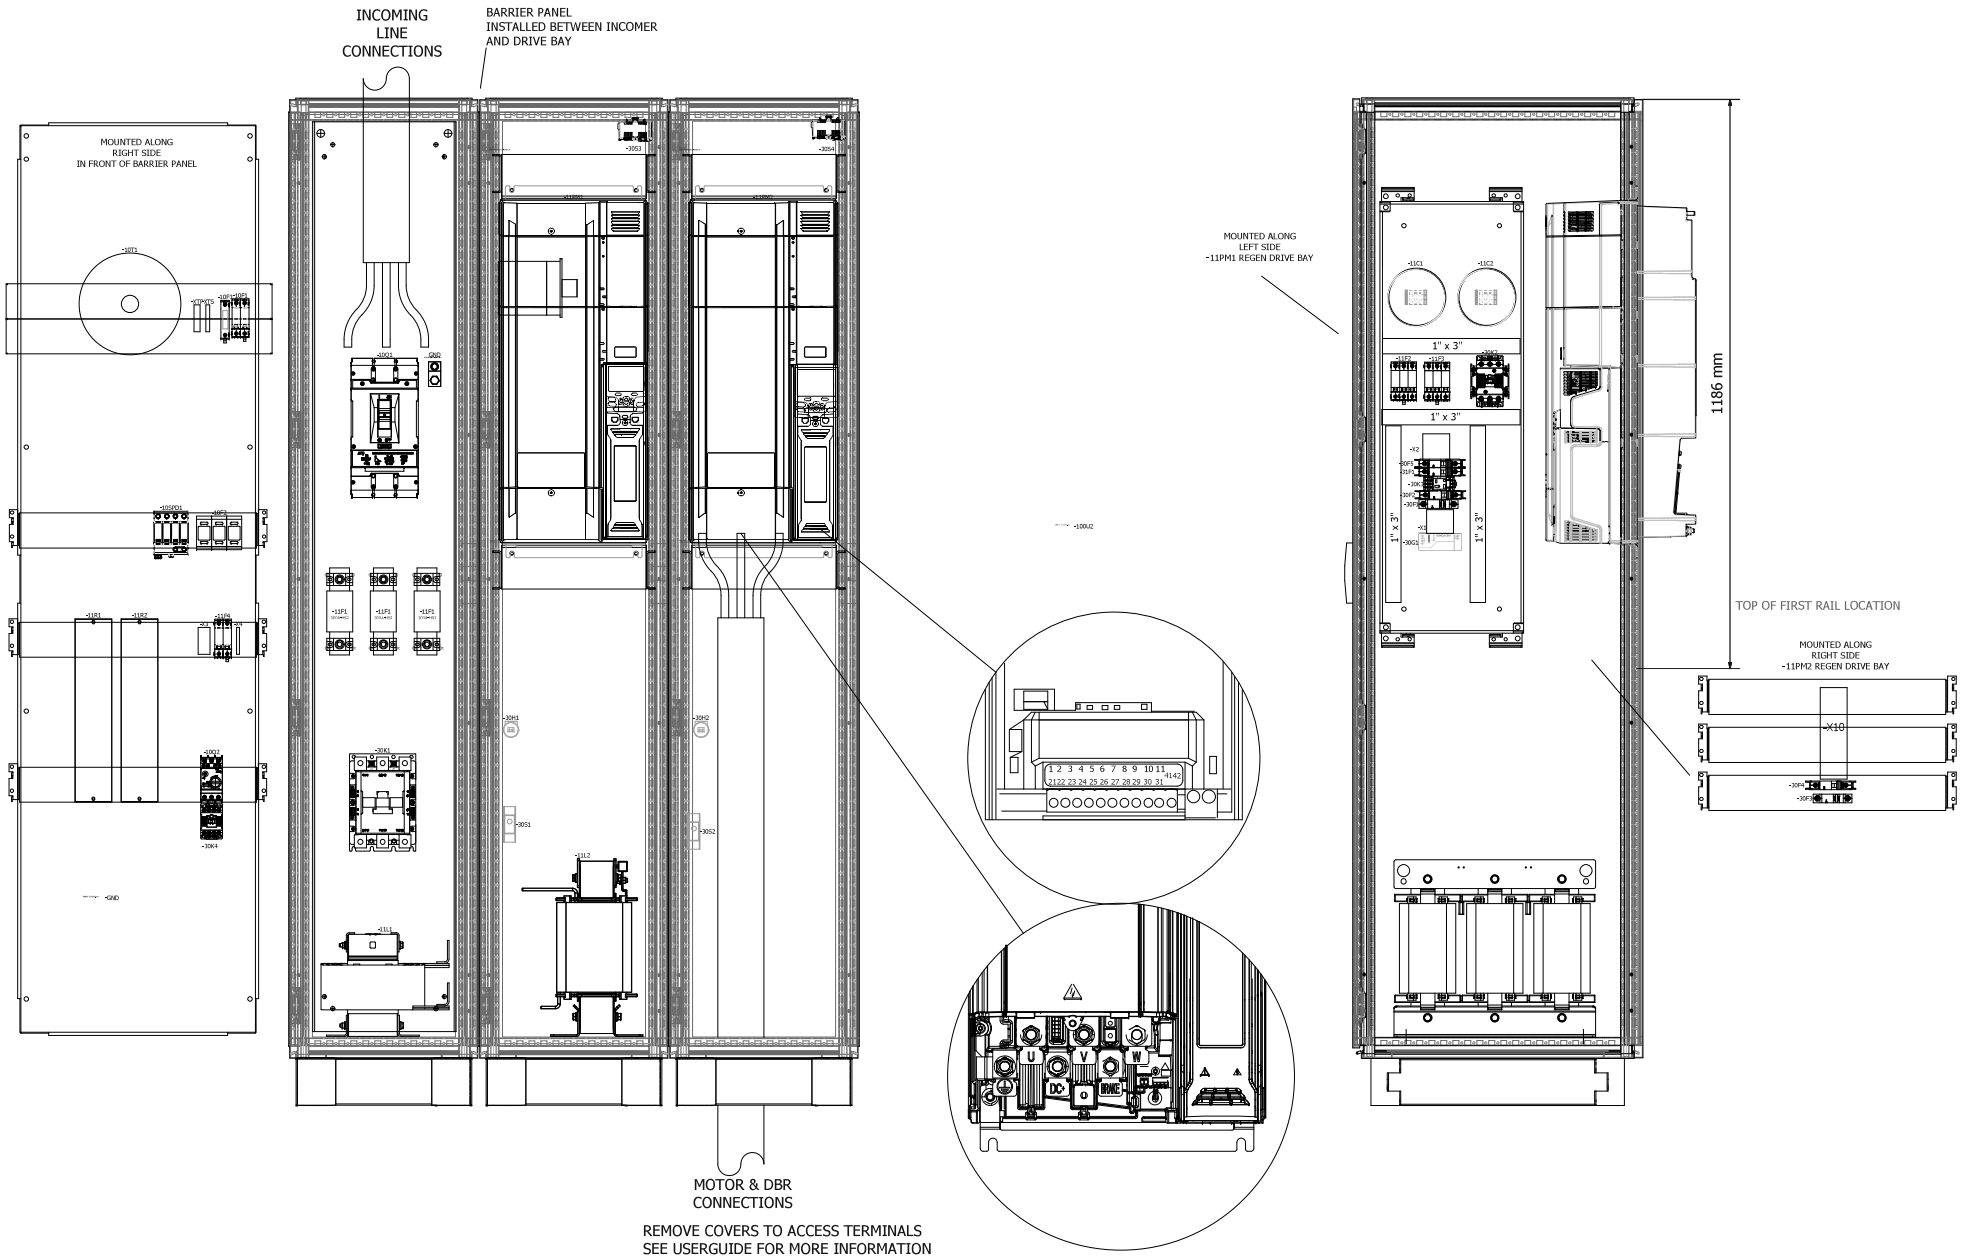

REMOVE COVERS TO ACCESS TERMINALS
SEE USERGUIDE FOR MORE INFORMATION

Rev 2.0 As Built	8/22/2022	rmucenieks	Date: 8/22/2022	CONTROL TECHNIQUES	12095 NW 39th Street	0DFS00026	DFS1H4 LAYOUT	=DFS
Rev. 1.0 For Manufacturing	3/1/2022	rmucenieks	Drawn By: rmucenieks		Coral Springs, FL 33065			Prev. Page: 31
			Approved By:					Next Page: 101
Revision	Date	Name						Page 100

THE DESIGNS AND INFORMATION CONTAINED IN THESE DRAWINGS ARE THE PROPERTY OF CONTROL TECHNIQUES. THEY MUST NOT BE COPIED OR COMMUNICATED TO THIRD PARTIES WITHOUT WRITTEN CONSENT.

FILE: Z:\ENGINEERING\ENGRD PRODUCT\0DFS0XXXX - NON-STANDARD DFS\0DFS00026 - NIDEC MOTOR CORP (ADVANCED MOTORS) TEST STAND REGEN\ENGINEERING

CT A STD V2

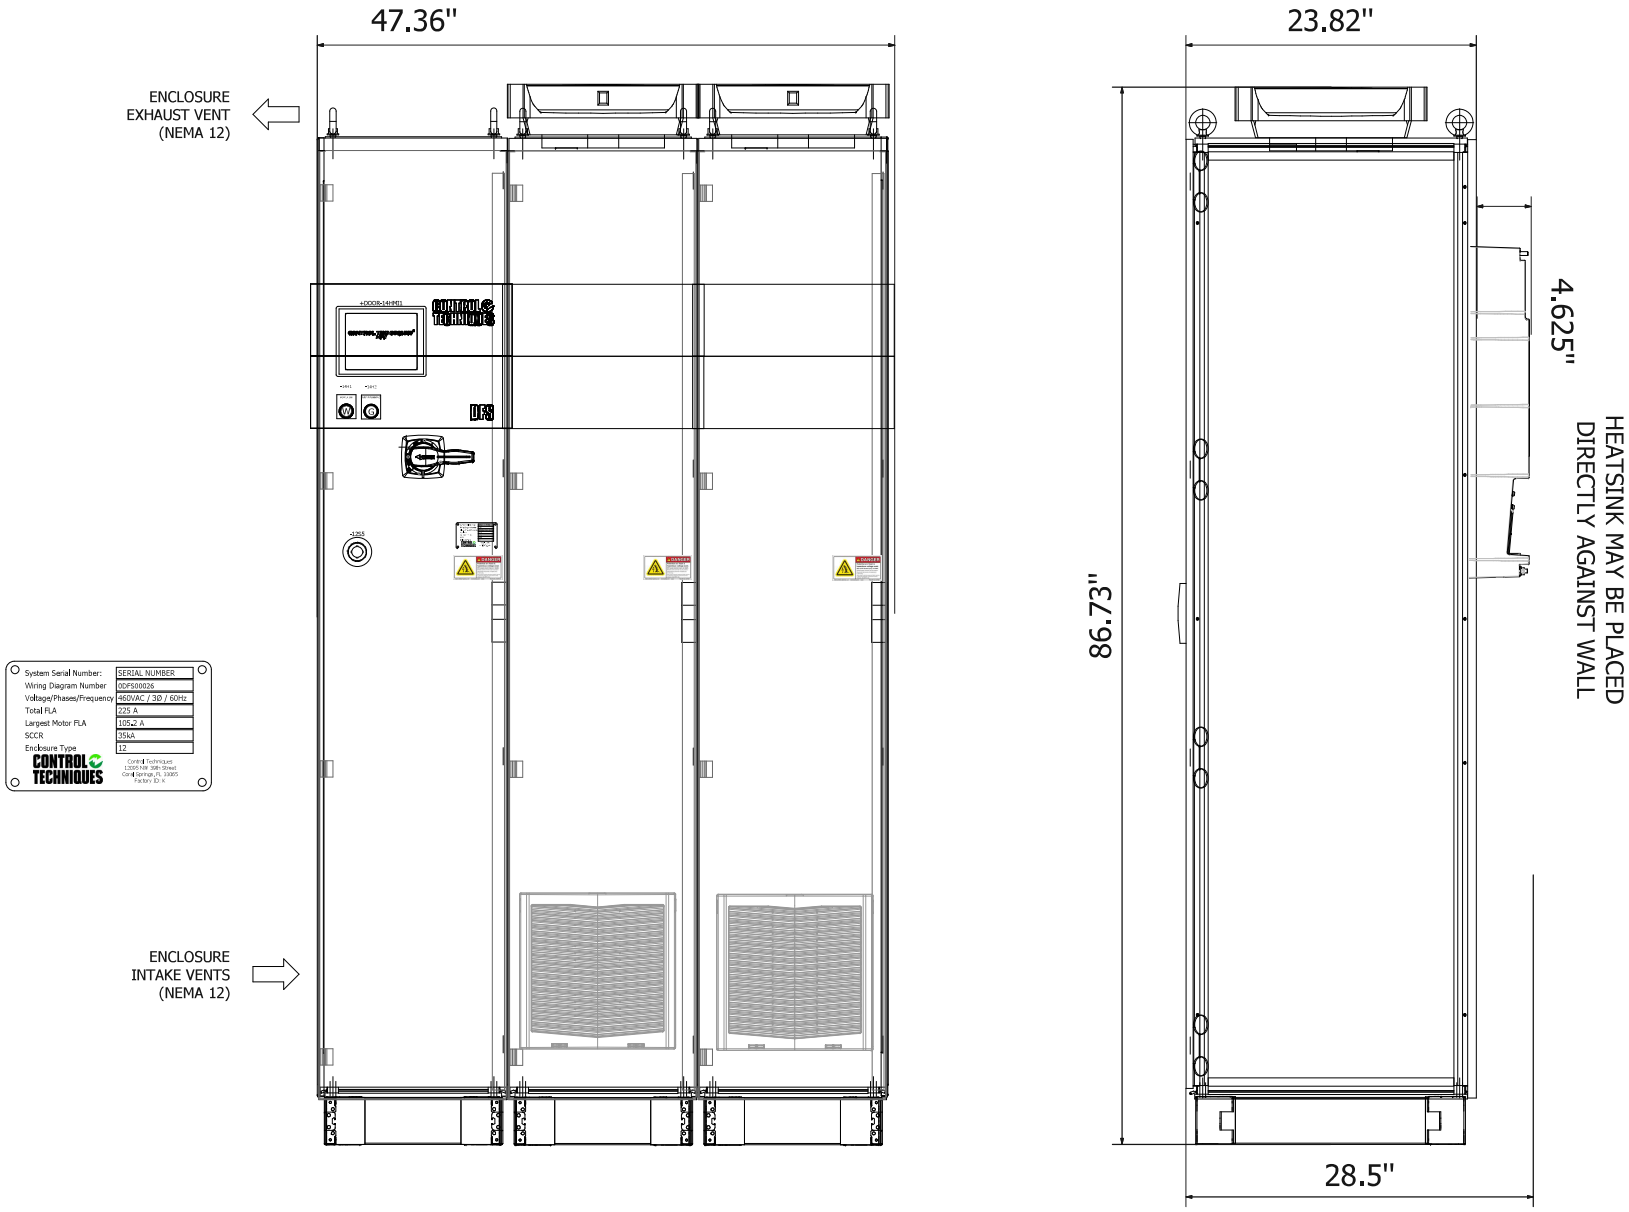

Rev 2.0 As Built	8/22/2022	rmucenieks	Date: 8/22/2022	CONTROL TECHNIQUES	12095 NW 39th Street	0DFS00026	DFS1H4 ENCLOSURE	=DFS
Rev. 1.0 For Manufacturing	3/1/2022	rmucenieks	Drawn By: rmucenieks		Coral Springs, FL 33065			Prev. Page: 105
			Approved By:					Next Page: 151
Revision	Date	Name						Page 150

THE DESIGNS AND INFORMATION CONTAINED IN THESE DRAWINGS ARE THE PROPERTY OF CONTROL TECHNIQUES. THEY MUST NOT BE COPIED OR COMMUNICATED TO THIRD PARTIES WITHOUT WRITTEN CONSENT.

FILE: Z:\ENGINEERING\ENGRD PRODUCT\0DFS0XXXX - NON-STANDARD DFS\0DFS00026 - NIDEC MOTOR CORP (ADVANCED MOTORS) TEST STAND REGEN\ENGINEERING

CT A STD V2